


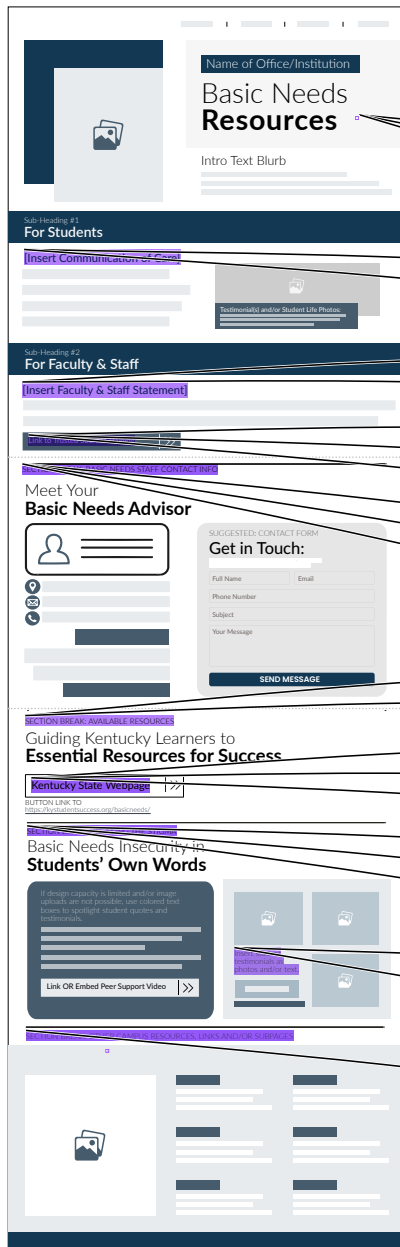


Summary of Comments on Low_Lift Institutional Wireframe.pdf

Page: 1

- Author:** Rjaa Ahmed **Date:** 6/26/26, 1:08:44DPM
Please insert your own branding, nomenclature, and copy here.
- Author:** rjaaahmed **Date:** 6/26/26, 12:59:41DPM
Please insert your own branding, nomenclature, and copy here.
- Author:** rjaaahmed **Subject:** Sticky Note **Date:** 6/26/26, 12:59:41DPM
Please insert your own branding, nomenclature, and copy here.
- Author:** rjaaahmed **Subject:** Comment on Text **Date:** 6/26/26, 12:59:54DPM
Refer to "Read Me: Suggested Wesbite Text" for language guidance for this section.
- Author:** rjaaahmed **Date:** 6/26/26, 12:59:54DPM
Refer to "Read Me: Suggested Wesbite Text" for language guidance for this section.
- Author:** rjaaahmed **Subject:** Comment on Text **Date:** 6/26/26, 1:00:14DPM
Refer to "Read Me: Suggested Wesbite Text" for language guidance for this section.
- Author:** rjaaahmed **Date:** 6/26/26, 1:00:14DPM
Refer to "Read Me: Suggested Wesbite Text" for language guidance for this section.
- Author:** Rjaa Ahmed **Date:** 6/26/26, 1:08:45DPM
This could be a link button (recommended for UX) or simply hyperlinked text if the former is difficult to implement.
- Author:** rjaaahmed **Date:** 6/26/26, 1:01:28DPM
This could be a link button (recommended for UX) or simply hyperlinked text if the former is difficult to implement.
- Author:** rjaaahmed **Subject:** Comment on Text **Date:** 6/26/26, 1:01:28DPM
This could be a link button (recommended for UX) or simply hyperlinked text if the former is difficult to implement.
- Author:** Rjaa Ahmed **Date:** 6/26/26, 1:08:45DPM
Section break title is for easy navigation for the wireframe only. Please don't include this language on your webpage.
- Author:** rjaaahmed **Subject:** Comment on Text **Date:** 6/26/26, 1:01:50DPM
Section break title is for easy navigation for the wireframe only. Please don't include this language on your webpage.
- Author:** rjaaahmed **Date:** 6/26/26, 1:01:50DPM
Section break title is for easy navigation for the wireframe only. Please don't include this language on your webpage.
- Author:** rjaaahmed **Subject:** Comment on Text **Date:** 6/26/26, 1:01:59DPM
Section break title is for easy navigation for the wireframe only. Please don't include this language on your webpage.
- Author:** rjaaahmed **Date:** 6/26/26, 1:01:59DPM
Section break title is for easy navigation for the wireframe only. Please don't include this language on your webpage.
- Author:** Rjaa Ahmed **Date:** 6/26/26, 1:08:45DPM
This could be a link button (recommended for UX) or simply hyperlinked text if the former is difficult to implement.
- Author:** rjaaahmed **Date:** 6/26/26, 1:01:33DPM
This could be a link button (recommended for UX) or simply hyperlinked text if the former is difficult to implement.
- Author:** rjaaahmed **Subject:** Comment on Text **Date:** 6/26/26, 1:01:33DPM
This could be a link button (recommended for UX) or simply hyperlinked text if the former is difficult to implement.
- Author:** rjaaahmed **Subject:** Comment on Text **Date:** 6/26/26, 1:02:09DPM
Section break title is for easy navigation for the wireframe only. Please don't include this language on your webpage.
- Author:** Rjaa Ahmed **Date:** 6/26/26, 1:08:45DPM
Section break title is for easy navigation for the wireframe only. Please don't include this language on your webpage.
- Author:** rjaaahmed **Date:** 6/26/26, 1:02:09DPM
Section break title is for easy navigation for the wireframe only. Please don't include this language on your webpage.
- Author:** rjaaahmed **Subject:** Comment on Text **Date:** 6/26/26, 1:06:45DPM
Quote images are a great way to break up text for easier readability. We encourage you to add them, as well as other student life/campus photos, here and in other places where you can so that your website feels engaging. In the absence of advanced UX/UI elements, simple images dispersed throughout the webpage can go a long way in elevating the page so it seems less like a collection of text blocks and hyperlinks.
- Author:** rjaaahmed **Date:** 6/26/26, 1:06:45DPM
Quote images are a great way to break up text for easier readability. We encourage you to add them, as well as other student life/campus photos, here and in other places where you can so that your website feels engaging. In the absence of advanced UX/UI elements, simple images dispersed throughout the webpage can go a long way in elevating the page so it seems less like a collection of text blocks and hyperlinks.
- Author:** Rjaa Ahmed **Date:** 6/26/26, 1:08:45DPM
Section break title is for easy navigation for the wireframe only. Please don't include this language on your webpage. Feel free to add a heading here that

Comments from page 1 continued on next page

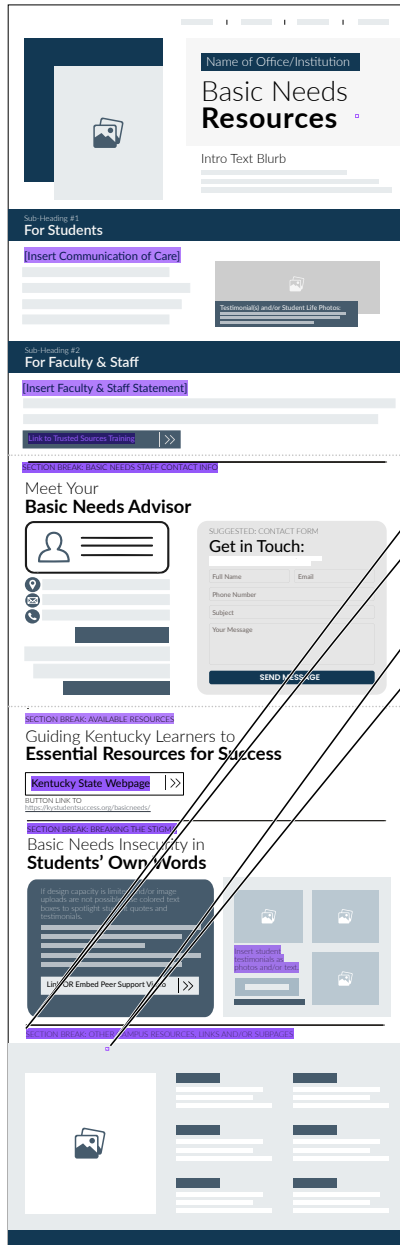

reads something like, "Other Resources."

Author: rjaaahmed Subject: Comment on Text Date: 6/26/26, 1:02:40PM

Section break title is for easy navigation for the wireframe only. Please don't include this language on your webpage. Feel free to add a heading here that reads something like, "Other Resources."

Author: rjaaahmed Date: 6/26/26, 1:02:40PM

Section break title is for easy navigation for the wireframe only. Please don't include this language on your webpage. Feel free to add a heading here that reads something like, "Other Resources."

Author: rjaaahmed Subject: Sticky Note Date: 6/26/26, 1:02:56PM

Include any other basic needs related webpages or resources housed elsewhere on your institution's website. The goals is to create a page that "centralizes" every service, resource of piece of guidance that a student experiencing BNI or staff/faculty trying to support them may need.

Refer to the "Read Me: Suggested Website Text" document for more information about what to include here.

Author: rjaaahmed Date: 6/26/26, 1:02:56PM

Include any other basic needs related webpages or resources housed elsewhere on your institution's website. The goals is to create a page that "centralizes" every service, resource of piece of guidance that a student experiencing BNI or staff/faculty trying to support them may need.

Refer to the "Read Me: Suggested Website Text" document for more information about what to include here.